

ANNEXURE

II

INFRASTRUCTURE

DETAILS

(VII) Auditorium:- (As per MSR)

Auditorium should be spacious enough to accommodate at least double the sanctioned/actual strength of students, so that it can be utilized for hosting functions of the college, educational conferences/ workshops, examinations etc. It should have proper stage with green room facilities. It should be well — ventilated and have proper lighting system. There should be arrangements for the use of all kinds of basic and advanced audio-visual aids. **3000 sqft**


OR

Multipurpose Hall:-

College of Nursing should have multipurpose hall, if there is no auditorium.

Yes

Adequate

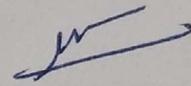

	(VIII) Canteen and Kitchen Facility: [Note: Verify Canteen Facility & Hygiene is monitored as per MUHS Circular No.18/2019 dated 19/03/2019.]	Yes	Adequate
	(IX) Common Rooms: Separate common rooms for boys and girls with adequate space and sitting arrangement shall be available.	Yes	Adequate
3	University Examination Infrastructure: Strong Room for examination a) (Area- 300 sq.ft, b) Shelf, c) Steel cupboard — 1, d) CCTV, Photocopier Machine, Examination hall with benches, Parking Facility for University vehicle, Guest house facility	Yes	Adequate
4	Other facilities: Hospital Waste Management, Medical Education Unit, Intercom Network, Playground, P.T Teacher or Instructor, Cafeteria, Facility for indoor games, Gymnasium / Gymkhana Facility, Is there any LMS (learning management system software) available	Yes	Adequate
5	Hostel facility: Boys (UG & PG), Girls (UG & PG), Interns, Residents, Warden/ Rector, Hygiene, Vending Machine etc.	Yes	Adequate
6	Hospital Details		
	Name of the Hospital : NOBLE HOSPITAL	Details on College Website	Adequate/ Inadequate
	Address: Hadapsar, Pune		
	Telephone No. :		
	Bed Strength : 325		
	Distance of Hospital from the College to which it is attached (in kms)		
	Number of beds registered as per BNH Act 352		
7	I. Total constructed area of Hospital Building as per MSR (.. Sq.mtr. Sq.ft.)	Yes	
	Whether the Hospital is Owned by the College / Management or Rented ? 76680	Yes	
	II. Hospital Administration Block as per MSR (Superintendent room, Deputy Superintendent room, Medical officers' room, Matron room, Assistant Matron room, Reception and Registration, etc.)	Yes	
	III. Out—Patient Departments (OPD) as per MSR Total Area of OPD Complex ...Sq.ft. 2000 sqft No. of OPD's	Yes	
	Facilities shall be as per MSR & all details shall be on college website.		
	IV. In Patient Departments (IPD) as per MSR Total Area of IPD Complex .. 74680 Sq.ft.	Yes	
	No. of IPD Departments..... Bed Distribution.....		
	Facilities shall be as per MSR & all details shall be on college website.		
	V. Operation Theatres Block as per MSR Total Area of OT Block ...sq.ft. No.of OTs available 11	Yes	
	Facilities shall be as per MSR & all details shall be on college website.		
	VI. Casualty Facilities State Government Permission Letter	Yes	
	VII. Central Clinical Laboratory: Well-equipped with separate sections for Pathology, Biochemistry and Micro-biology. Attached toilet shall be there for collection of urine samples. Other diagnostic tools for ECG or TMT etc. shall be provided.	Yes	
	VIII. Radiology or Sonography Section: Radiologist chamber, X-ray room, Dark room, film drying room, store room, patients waiting and dressing room, reception or registration or report room.	Yes/No	
	IX. Labour Room :	Yes/No	

Dean/ Principal Stamp & Signature

INFRASTRUCTURE


OF

COLLEGE



THIRD FLOOR

BLOCKS	SIZE	AREA sq.m
A	30.77 X 71.40	2196.97
B	2.30 X 4.35	10.00
DEDUCTIONS		
D1	0.32 X 8.08	2.59
D2	3.20 X 8.25	26.40
D3	2.97 X 8.02	23.81
D4	2.87 X 12.67	36.36
D5	10.86 X 1.50	16.29
D6	9.30 X 1.50	13.95
D7	24.03 X 4.40	105.73
D8	4.20 X 10.80	45.36
D9	6.00 X 4.78	28.68
D10	3.80 X 35.05	133.19
D11	3.05 X 34.90	106.44
D12	1.73 X 3.55	6.14
D13	1.73 X 3.55	6.14
D14	1.73 X 3.55	6.14
D15	4.61 X 1.50	6.92
D16	7.80 X 1.50	11.70
D17	30.45 X 1.50	45.67
D18	17.03 X 1.50	25.54
D19	7.80 X 1.50	11.70
D20	1.50 X 14.60	21.90
D21	1.50 X 16.90	25.35
D22	8.94 X 1.50	13.41
D23	9.04 X 1.50	13.56
D24	1.50 X 16.90	25.35
D25	1.50 X 14.60	21.90
D26	12.60 X 2.64	33.26
D27	3.15 X 6.30	19.84
D28	2.74 X 5.91	16.19
D29	5.70 X 3.38	19.26
D30	9.30 X 1.95	18.13
D31	6.00 X 2.10	12.60
D32	2.75 X 7.65	21.03
D33	1.80 X 10.80	19.44
D34	6.00 X 6.61	39.66
D35	2.94 X 7.04	20.69
D36	6.44 X 3.77	24.27
D37	8.48 X 3.55	30.10
D38	2.94 X 16.66	48.98
D39	3.00 X 4.13	12.76
D40	3.15 X 3.60	11.34
D41	0.5X227X1.80X1.80	5.09
D42	2.97 X 2.65	7.87
D43	2.97 X 2.65	7.87
D44	2.50 X 2.97	7.43
D45	2.50 X 2.97	7.43
D46	2.30 X 2.97	6.83
D47	2.00 X 1.80	3.60
D48	2.00 X 1.80	3.60
TOTAL DEDUCTIONS 1171.33		
NET TOTAL 1035.64		

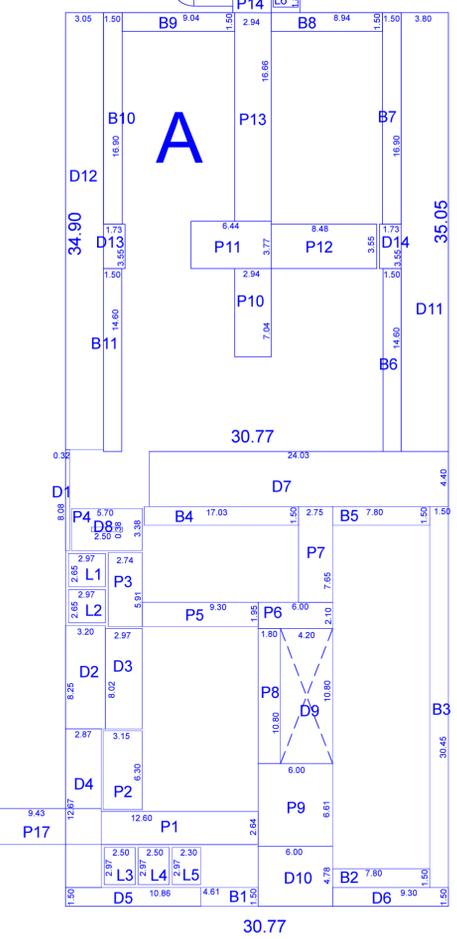


BALCONY AT THIRD FLOOR


B1	4.61 X 1.50	6.92
B2	7.80 X 1.50	11.70
B3	30.45 X 1.50	45.67
B4	17.03 X 1.50	25.54
B5	7.80 X 1.50	11.70
B6	1.50 X 14.60	21.90
B7	1.50 X 16.90	25.35
B8	8.94 X 1.50	13.41
B9	9.04 X 1.50	13.56
B10	1.50 X 16.90	25.35
B11	1.50 X 14.60	21.90
TOTAL		222.99

PREMIUM AREA STAIRCASE & PASSAGE AT THIRD FLOOR

P1	12.60 X 2.64	33.26
P2	3.15 X 6.30	19.84
P3	2.74 X 5.91	16.19
P4	5.70 X 3.38	19.26
P5	9.30 X 1.95	18.13
P6	6.00 X 2.10	12.60
P7	2.75 X 7.65	21.03
P8	1.80 X 10.80	19.44
P9	6.00 X 6.61	39.66
P10	2.94 X 7.04	20.69
P11	6.44 X 3.77	24.27
P12	8.48 X 3.55	30.10
P13	2.94 X 16.66	48.98
P14	3.00 X 4.13	12.76
P15	3.15 X 3.60	11.34
P16	0.5X227X1.80X1.80	5.09
P17	9.43 X 2.87	27.06
DEDUCTIONS		
D8	2.50 X 0.38	0.95
TOTAL		378.75

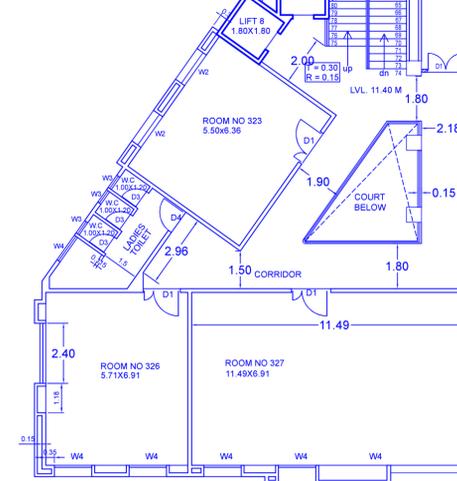

THIRD FLOOR PLAN

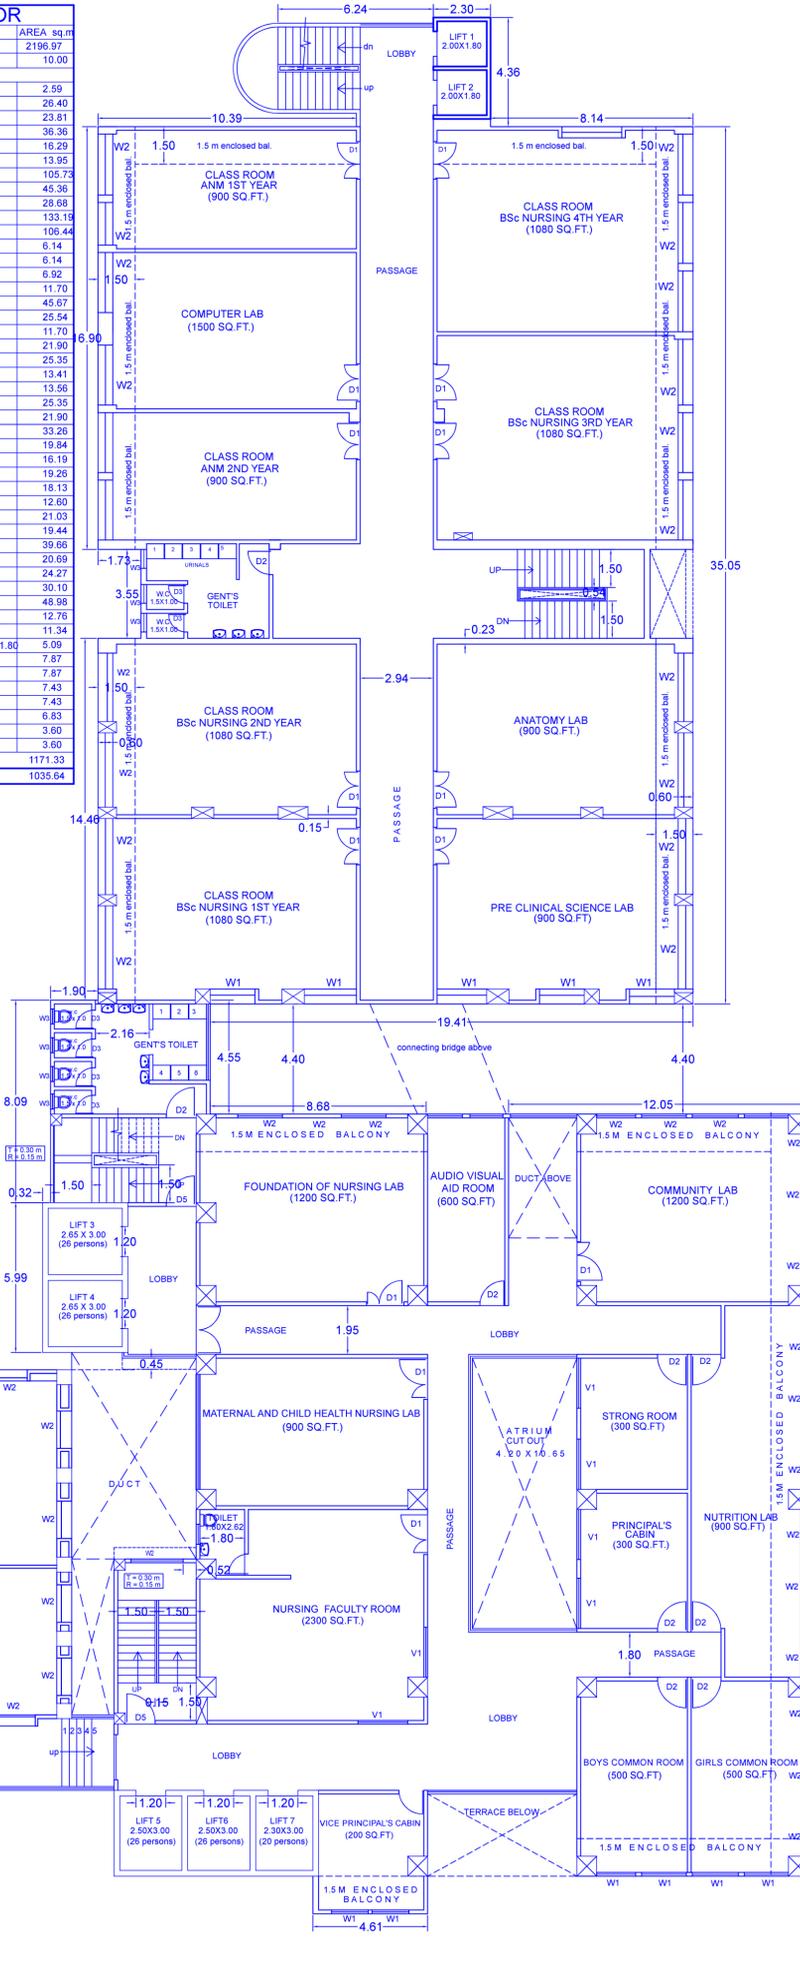

TRUE COPY
[Signature]
(CA 89/7454)

FOURTH FLOOR PLAN


TITLE
RECORD PLAN OF LIBRARY BUILDING & CLASSROOM & JAYANTRAO TILAK BHAVAN 2, ON PLOT BEARING F.P. NO. 425B, S.NO. 540 IN TPS NO 3 (FINAL) AT GULTEKDI, PUNE FOR TILAK MAHARASHTRA VIDYAPEETH

DRG NO	SCALE	DATE	NORTH
322/10/3R1	PLANS SECTION 1:100 ELEVATIONS	29/7/11	

KEN-ARCH
ARCHITECTS ENGINEERS INTERIOR DESIGNERS & GOVT VALUERS
YASHOMANGAL, SHILAVIHAR COLONY, OPP YATRI HOTEL, ERANDWANA NEAR DASHBHUA GANPATI, PUNE-411038, TEL (020) 32527244

OWNER - TILAK MAHARASHTRA VIDYAPEETH, PUNE
ARCHITECT'S SIGN
REGISTRAR
AR ARJUN KANHERE (C.A.837454)

LATEST REVISED SANCTION SANTIION NO: CC / 720 / 11 DATED 30.5.2011

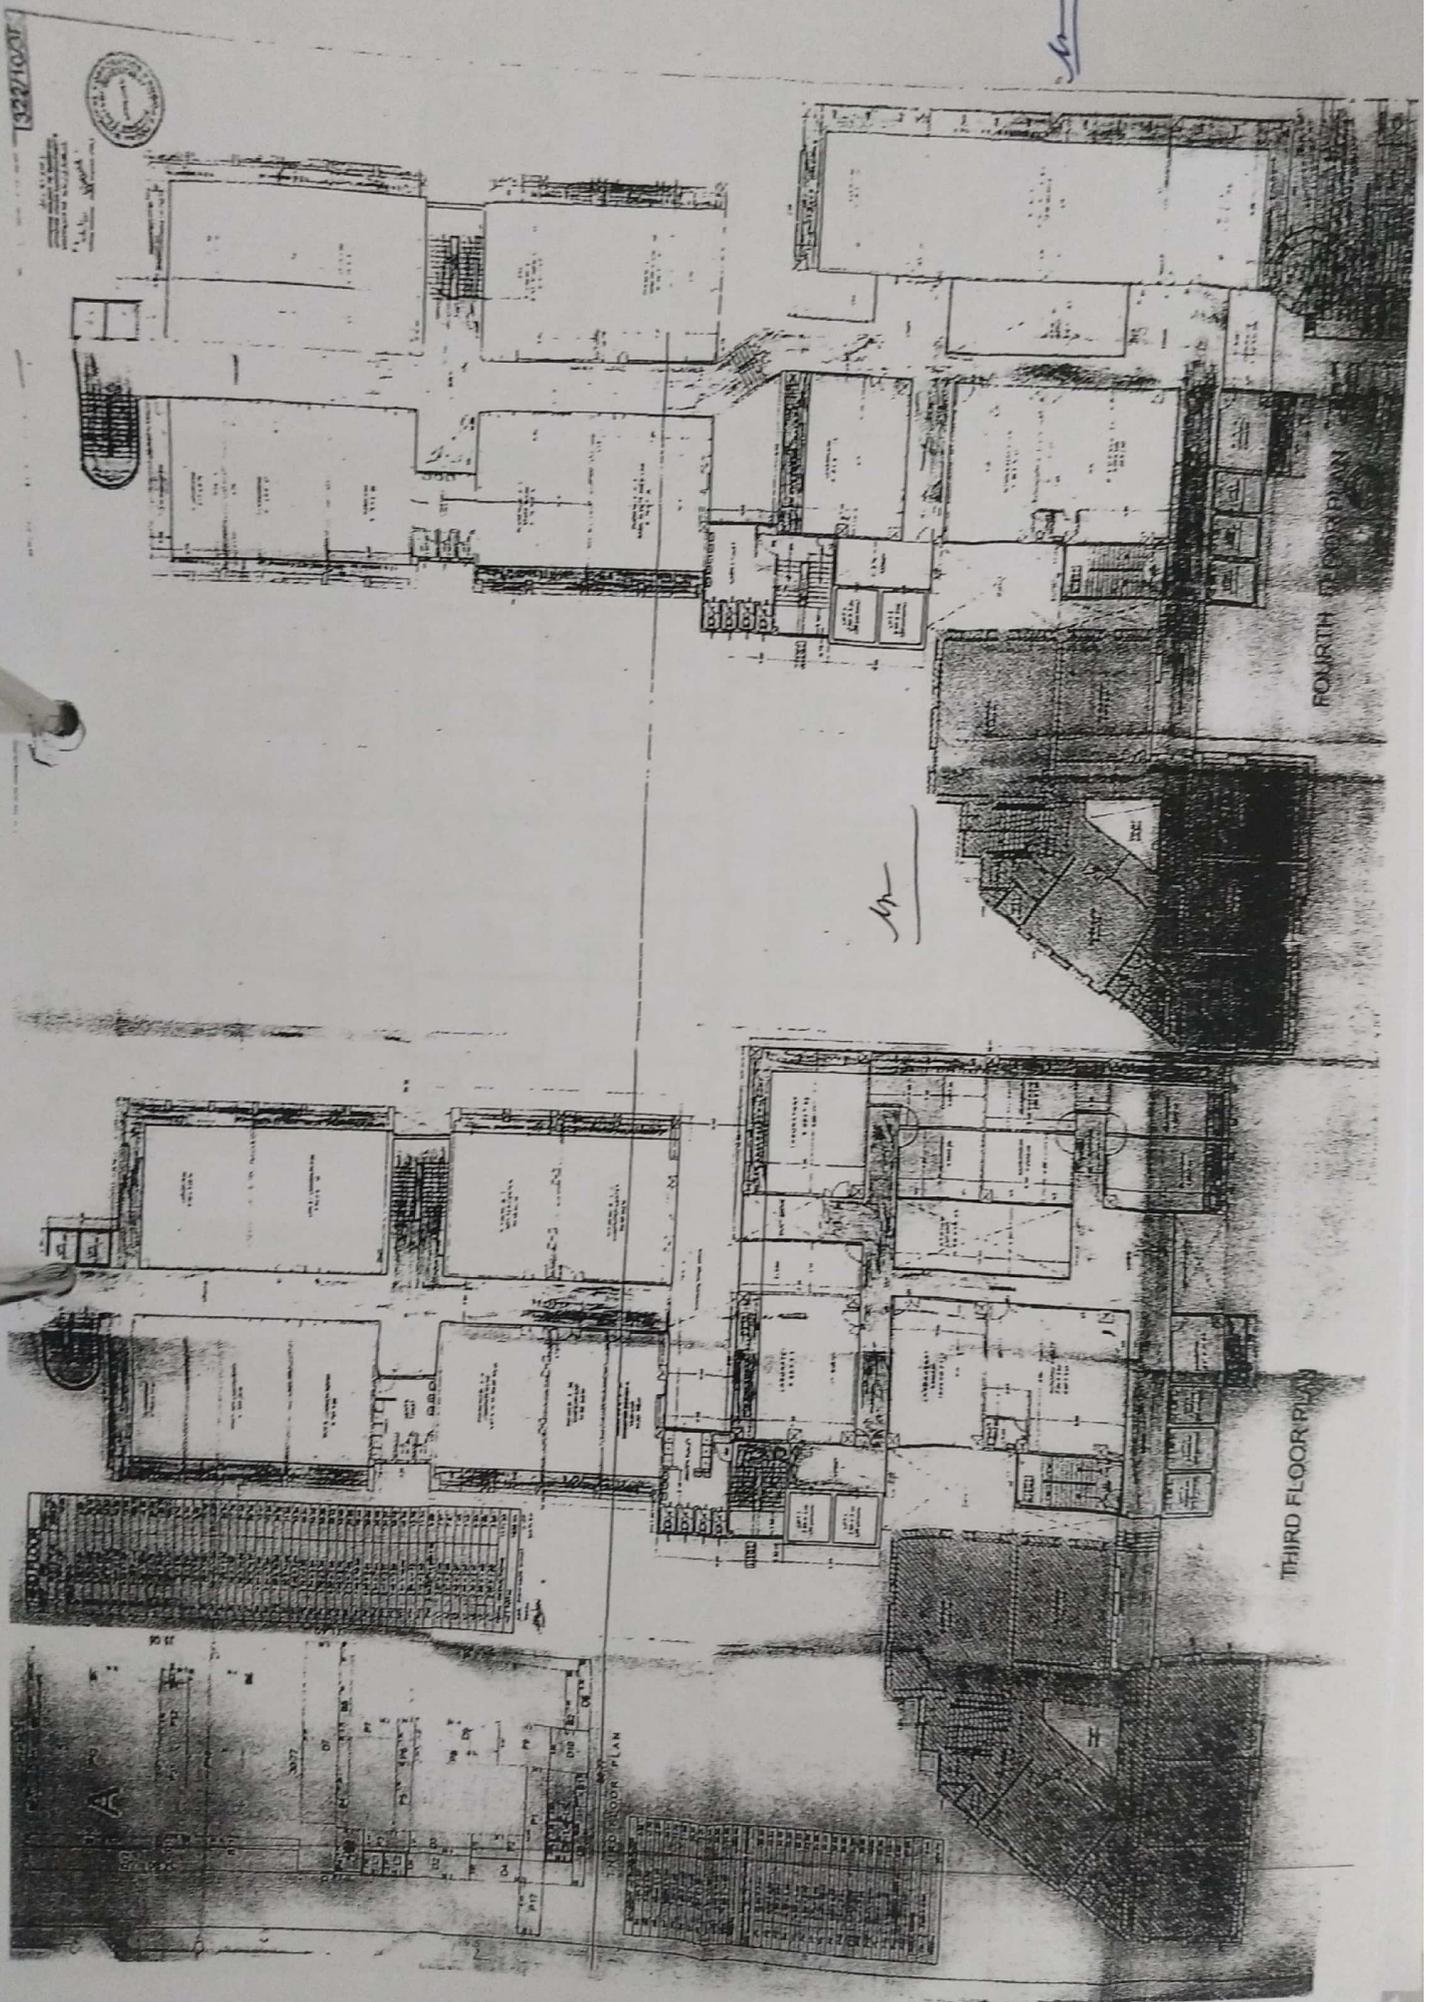

CERTIFIED COPY 12
 STAMP OF APPROVAL
 TRUE COPY CERTIFICATE
 822/2-7




APPROVED SUBJECT TO THE APPROPRIATE LOCAL JURISDICTION DATE 11/11/2011
 S.B. MOHAM
 BUSINESS ARCHITECT


FLOOR	AREA	PERCENT
FIRST	10,000	10.00
SECOND	10,000	10.00
THIRD	10,000	10.00
FOURTH	10,000	10.00
STILT	10,000	10.00
PARKING	10,000	10.00
TOTAL	100,000	100.00

BUILDING PLAN


PLANNED GIRLS HOSTEL
 10000 S. BAY ST.
 MIAMI BEACH, FLORIDA 33154
 PROJECT NO. 11-11-11-001
 DATE 11/11/2011

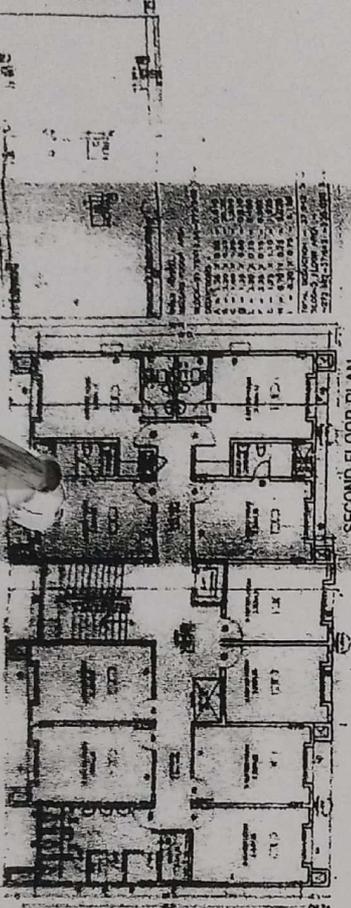

SECOND FLOOR PLAN

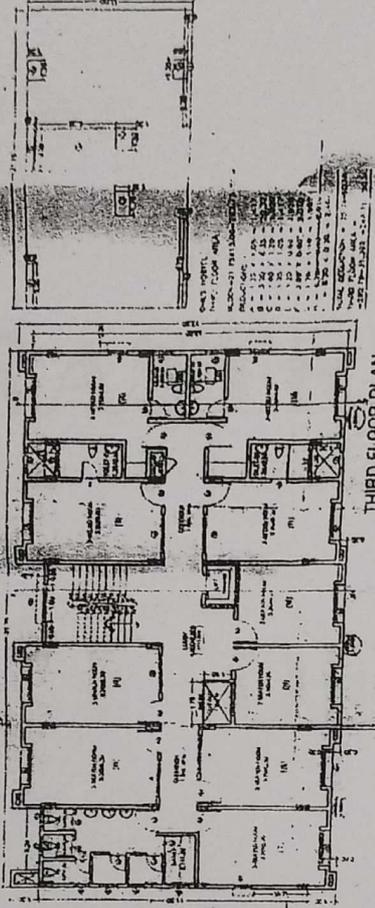


THIRD FLOOR PLAN

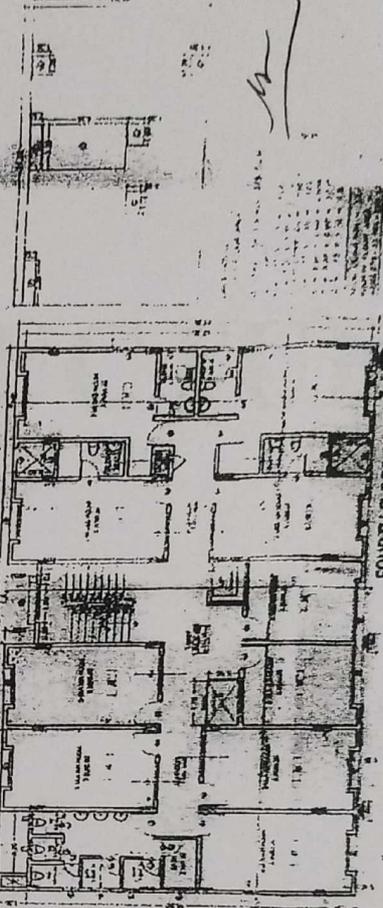


FOURTH FLOOR PLAN


(Includes notes for SANITARY and WATER RESTROOM)

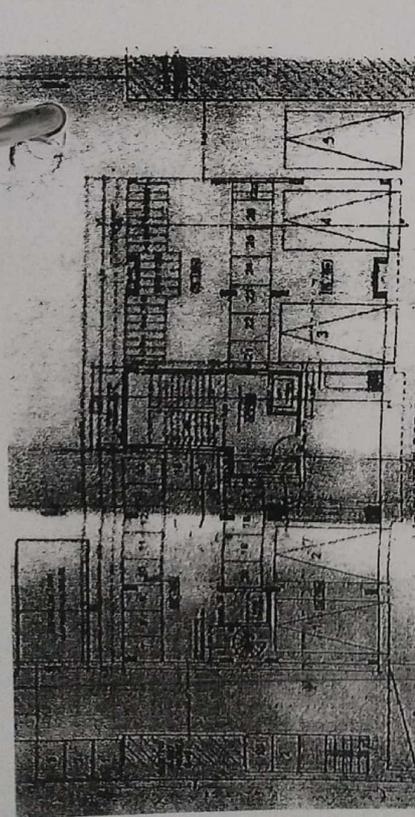

PARKING FLOOR PLAN

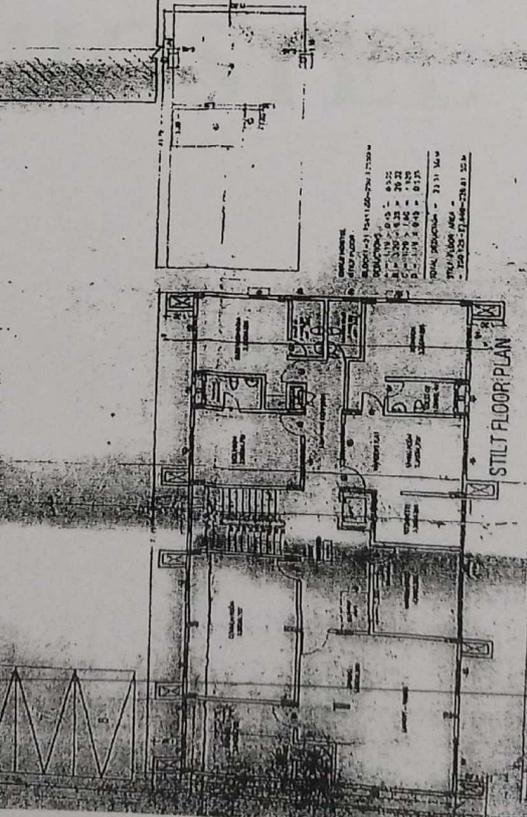

STILT FLOOR PLAN

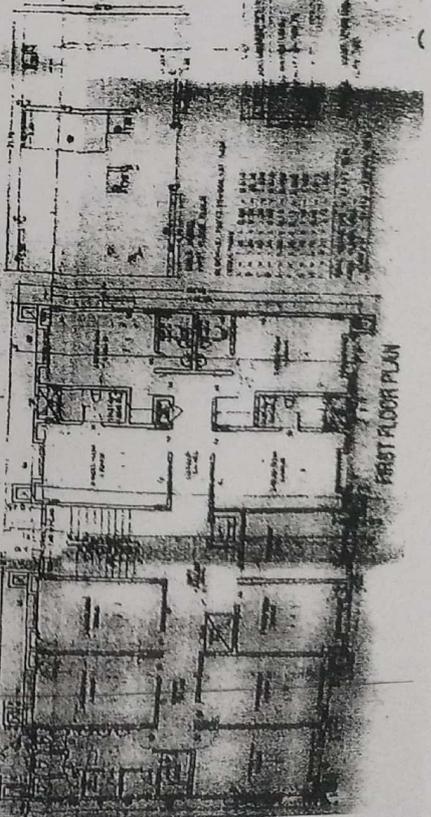

FIRST FLOOR PLAN

AREA SCHEDULE
 FLOOR PLAN
 1. 10,000 - 10.00
 2. 10,000 - 10.00
 3. 10,000 - 10.00
 4. 10,000 - 10.00
 5. 10,000 - 10.00
 TOTAL AREA = 50,000
 TOTAL PERCENT = 100.00

INFRASTRUCTURE

OF


HOSTEL

4 JUL 2006

RM : D47 67 / 2008
and 4.00. Floor plan

DOOR WINDOW SCHEDULE

NO.	TYPE	SIZE	CALL	UNIF.	NO. OR G.C.	NO. OR P.P.
D	2150x2000	—	2535	DR	—	DR
B1	1000x1250	—	2535	DR	—	DR
B2	1500x2000	—	2535	DR	—	DR
B3	1500x2000	—	2535	DR	—	DR
B4	2000x2000	—	2535	DR	—	DR
B5	2000x2000	—	2535	DR	—	DR
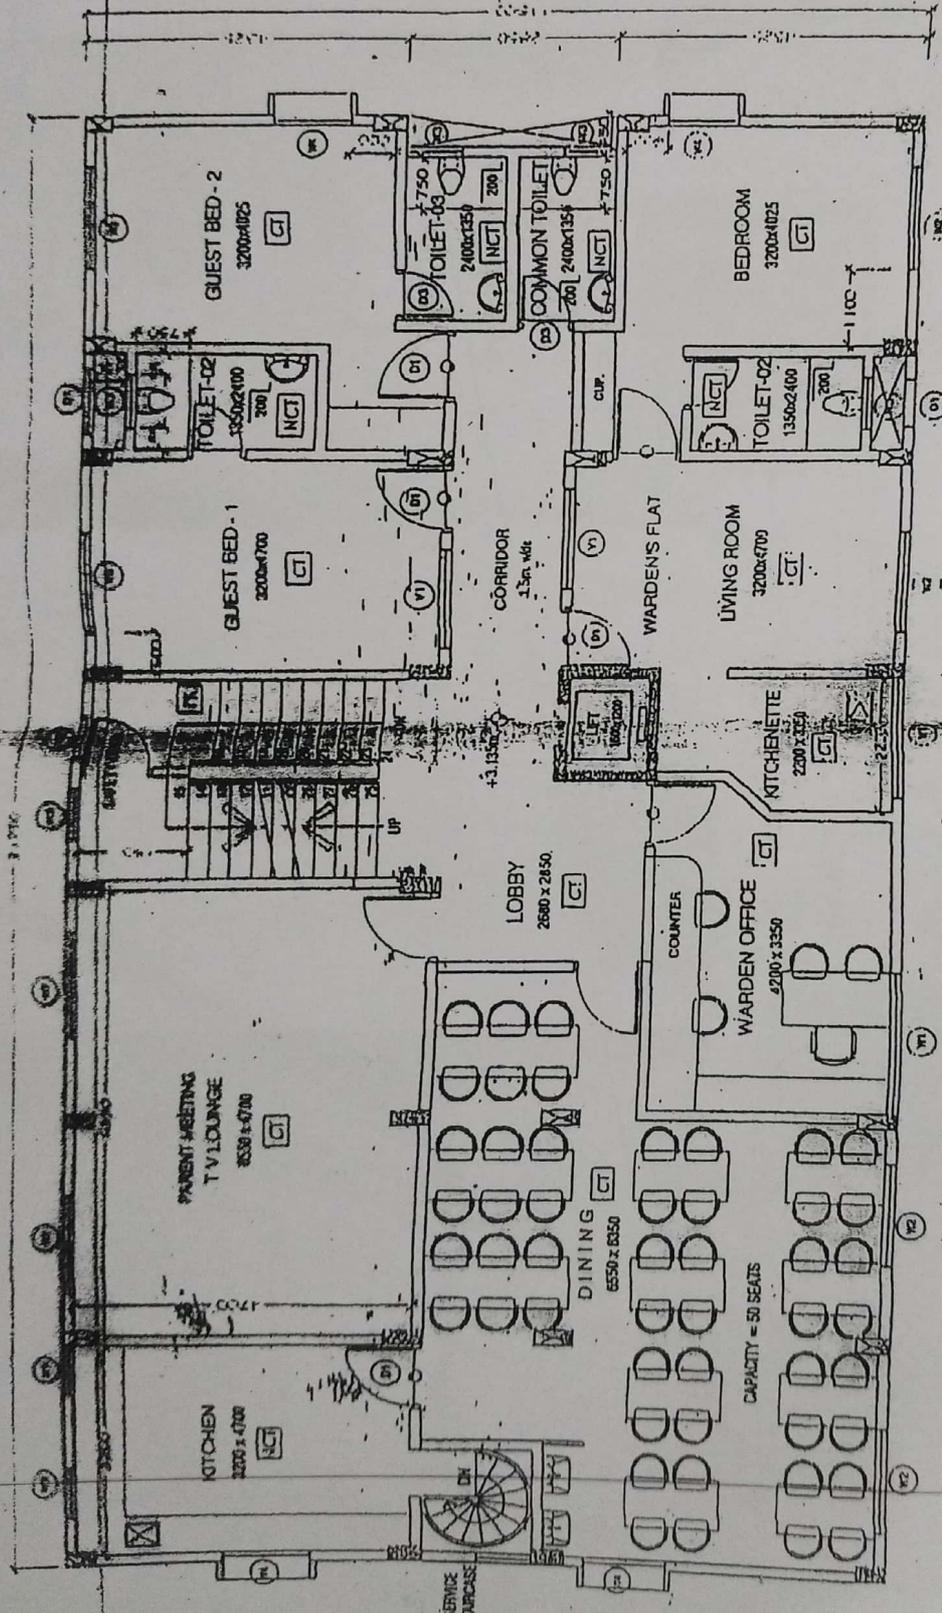

HOSTEL BUILDING

BUILT UP AREA = 245.30 SQ.M.

STILT FLOOR PLAN

GUEST BED = 2 ROOMS

DINING ROOM FOR 50 SEATS

KITCHEN

T.V. LOUNGE (with Parent Meeting)

WARDEN'S OFFICE

WARDEN'S FLAT

